



Ground Floor
Control Point

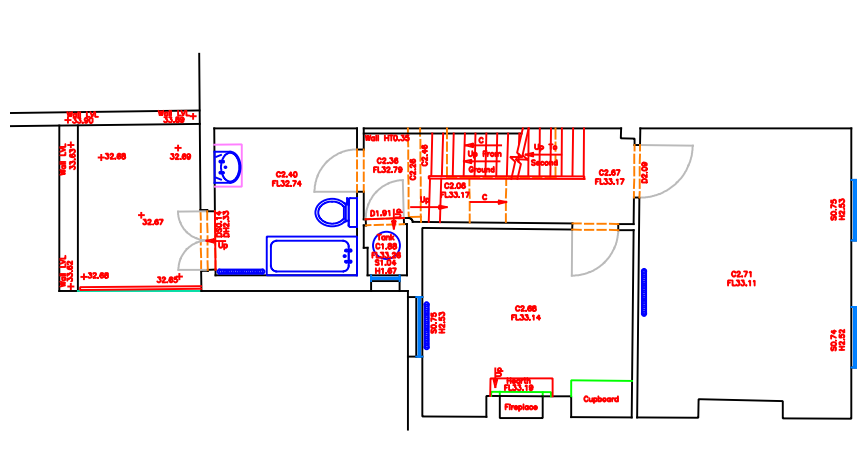

First Floor
Control Point

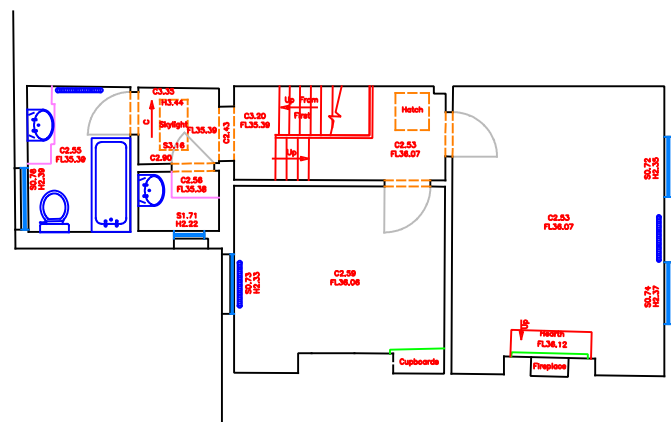

Second Floor
Control Point


NOTES

1. Levels - Ordnance Survey GPS Datum.
2. Grid - Ordnance Survey National Grid based on GPS Observations.
3. North Point indicative only.
4. Drainage pipe sizes are approximate as gauged from the surface.
5. Expert identification is advised for tree species.
6. Boundary detail may not represent the extent of legally conveyed ownership.
7. Survey carried out to client specification and in accordance with RICS publication: SURVEYS OF LAND, BUILDINGS & UTILITY SERVICES AT SCALES 1:500 & LARGER, 2nd EDITION.
8. Copyright of this survey, and all associated drawings and digital information, is owned by Bury Associates Limited. This information may not be sold on to a third party without prior permission of Bury Associates Limited and payment of the appropriate fee.
9. Internal door heights are evaluated on site, and are to be assumed as approximately 2.00m unless otherwise specified.

Websharecloud

With your survey we have provided a link which you can view your laser scanned building online. The Webshare allows you to go room to room viewing the building as surveyed. Take measurements, make mark ups and create ortho images.

[Bury Associates Websharecloud Link](#)

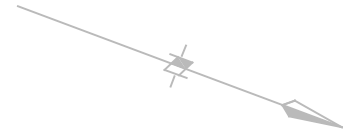

KEY

- | | |
|--------------------------|------------------------------------|
| INTERNAL FEATURES | SLOPING CEILING (ARROW POINTS UP) |
| B BEAM HEIGHT | SLOPING BEAM (ARROW POINTS UP) |
| C CEILING HEIGHT | SLOPING FLOOR (ARROW POINTS UP) |
| D DOOR HEIGHT | DOOR HEAD HEIGHT (ARROW POINTS UP) |
| DS DOOR SILL HEIGHT | FALSE CEILING |
| FC FALSE CEILING | FLOOR LEVEL |
| FL FLOOR LEVEL | HEAD HEIGHT |
| H HEAD HEIGHT | STEP UP (ARROW POINTS UP) |
| SP SPRING HEIGHT | SILL HEIGHT |
| S SILL HEIGHT | SPRING HEIGHT |
| LS LIGHT SWITCH | ELECTRICAL SOCKET |
| ES ELECTRICAL SOCKET | FIRE ALARM LIGHT |
| TS TV SOCKET | BOILER |
| IM IMMERSION HEATER | RAFTER |
| R RADIIATOR | |



Bury Associates Ltd

T: 01905 622495
survey@buryassociates.co.uk
www.buryassociates.co.uk

Suite 4 Cadbury House,
Blackpole East,
Worcester, WR3 8SG



CLIENT	Client	123 The Street Townville TV1 1AA
PROJECT	99 The Road London W17 2AA	
DRAWING TITLE	Floor Plans Ground Floor to Second Floor	
SCALE	1:50	DATE 29/08/18
DRAWING NO.	BA27270818-02	SHEET SIZE A1
		SURVEYOR SB
		DRAWN BY TM/SP